RED LINE – RELOCATED TO MEET EXISTING MAIN ON OLD SECTION OF NELSON ST.

SEE W-295

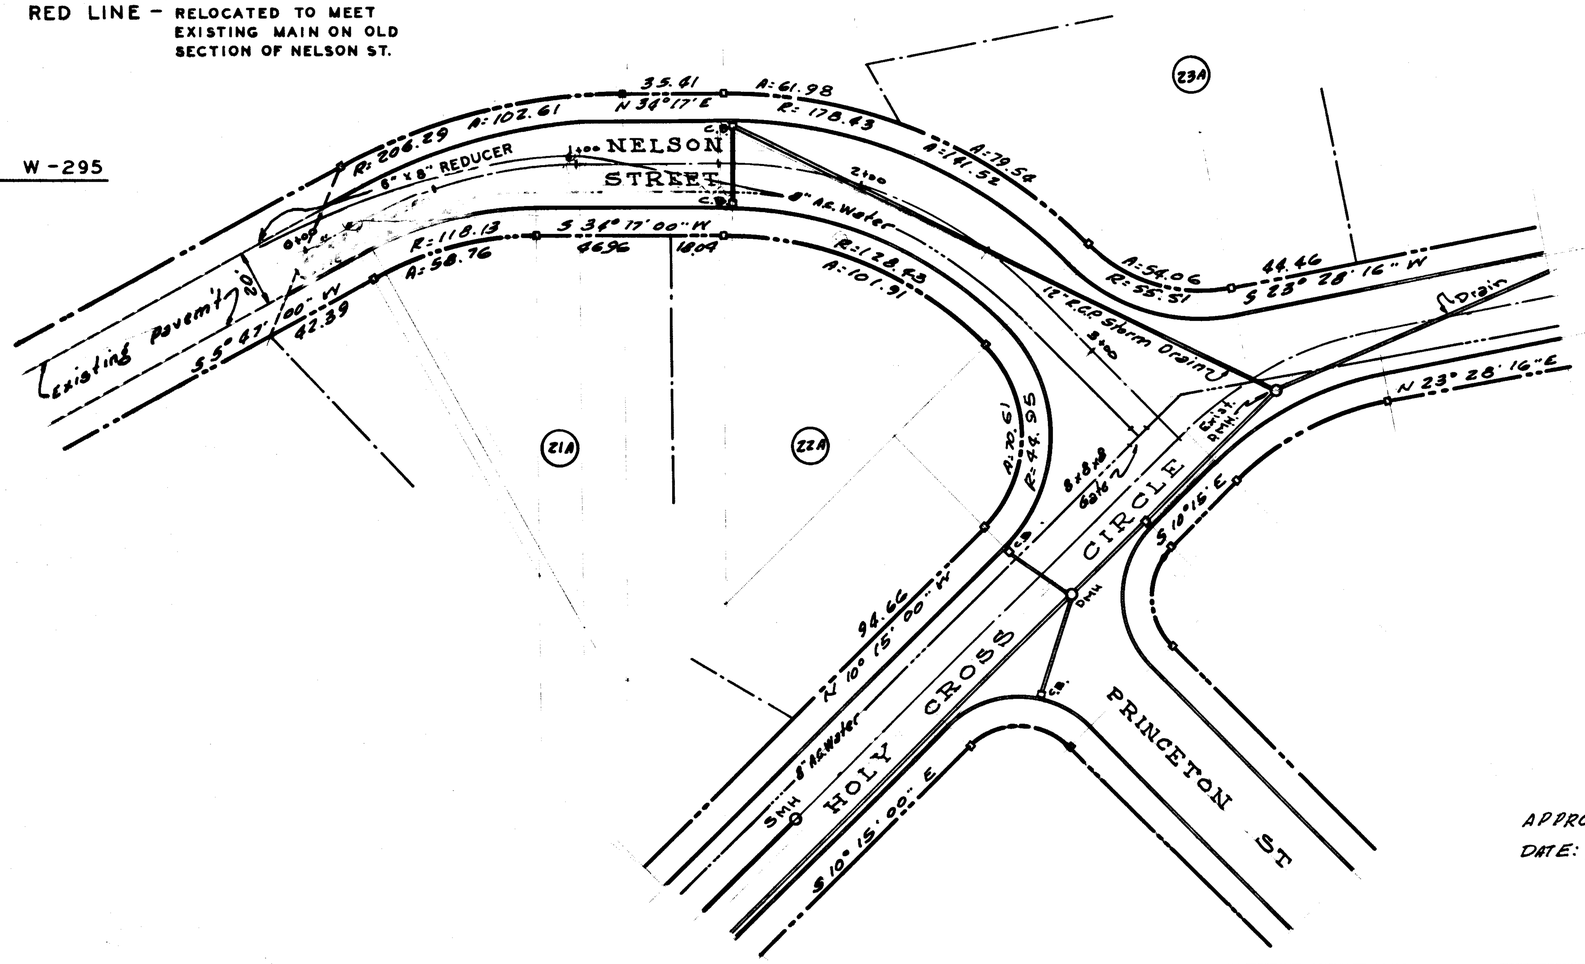

APPROVED BY EAST LONGMEADOW PLANNING BOARD
DATE: 9/12/68
James L. Thurin
Chairman

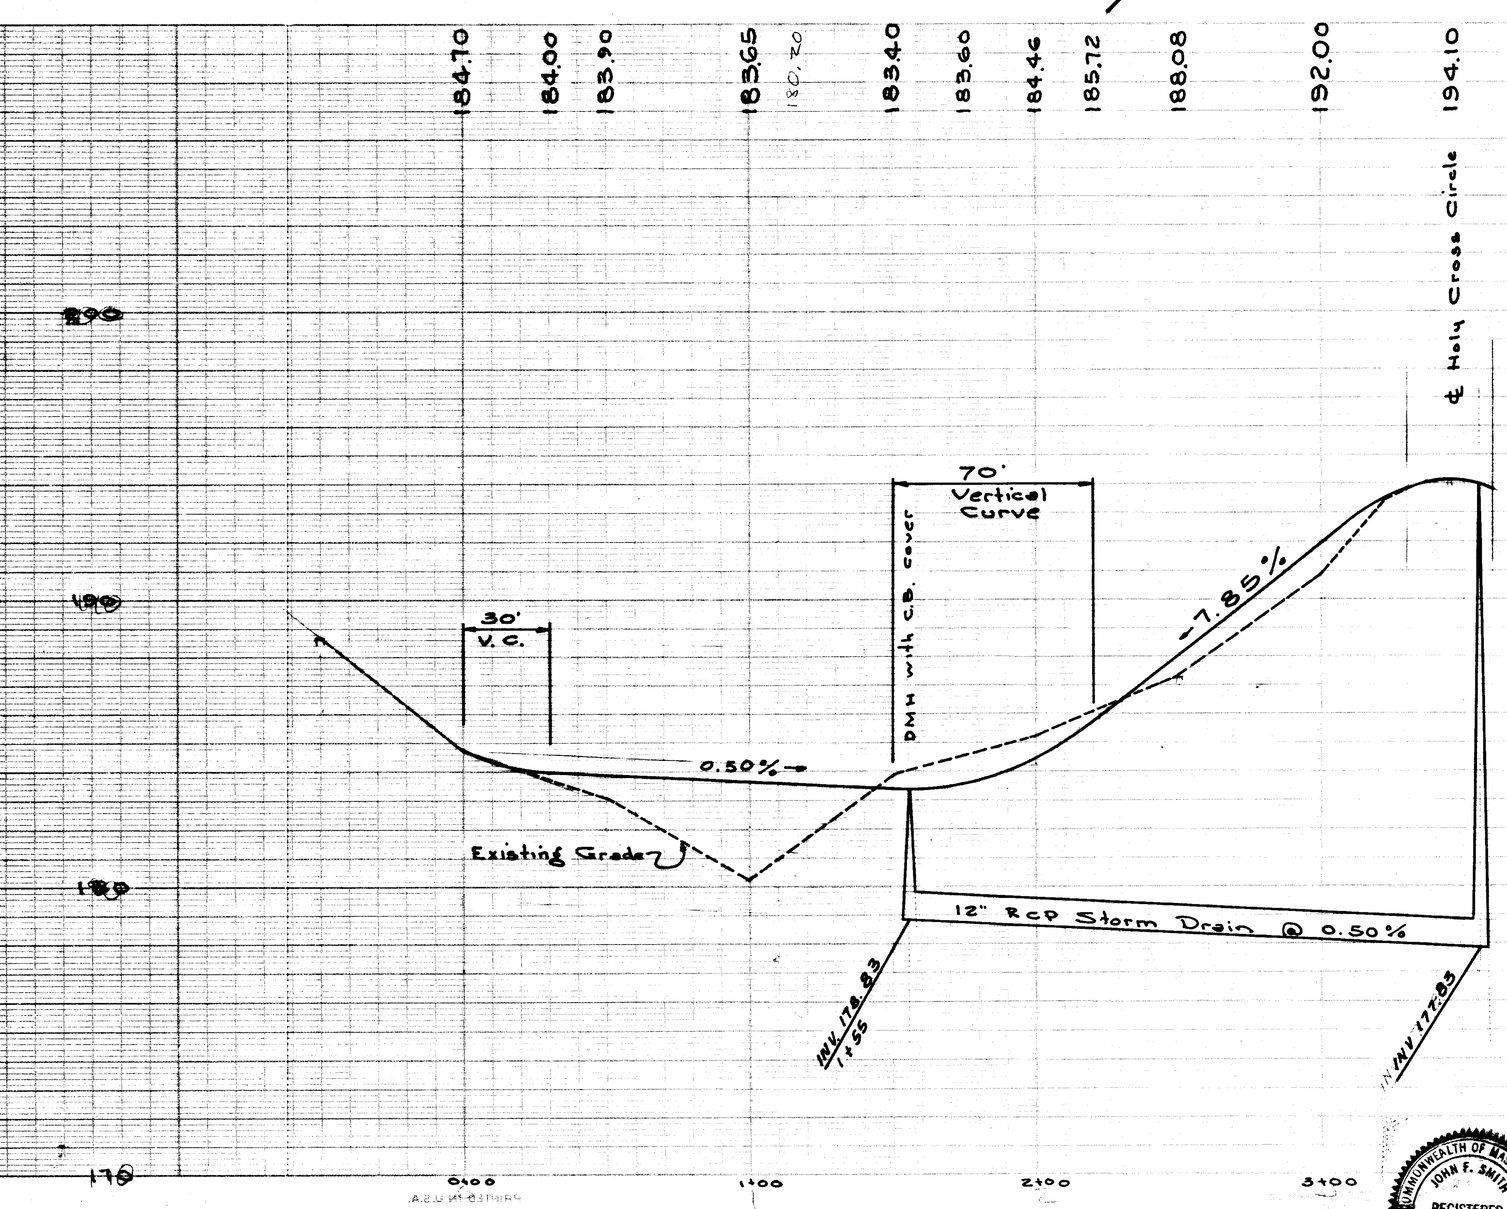

SECTION "C"
REVISED
PLAN AND PROFILE
NELSON STREET EAST LONGMEADOW
FOR
PREMIUM HOMES INC.
167 ELM ST. N. AGAWAM, MASS.

W-296

Scale: 1" = 4'-0" Vert. AND 1" = 40'-0" Horz.

JULY 1968

COMMONWEALTH OF MASSACHUSETTS JOHN F. SMITH REGISTERED No. 11312 PROFESSIONAL ENGINEER

COMMONWEALTH OF MASSACHUSETTS JOHN F. SMITH REGISTERED No. 5394 LAND SURVEYOR

S M I T H & W A L L E N
ENGINEERING COMPANY INC.
602 WHITE ST. SPRINGFIELD, MASS.

SHEET 2 OF 2