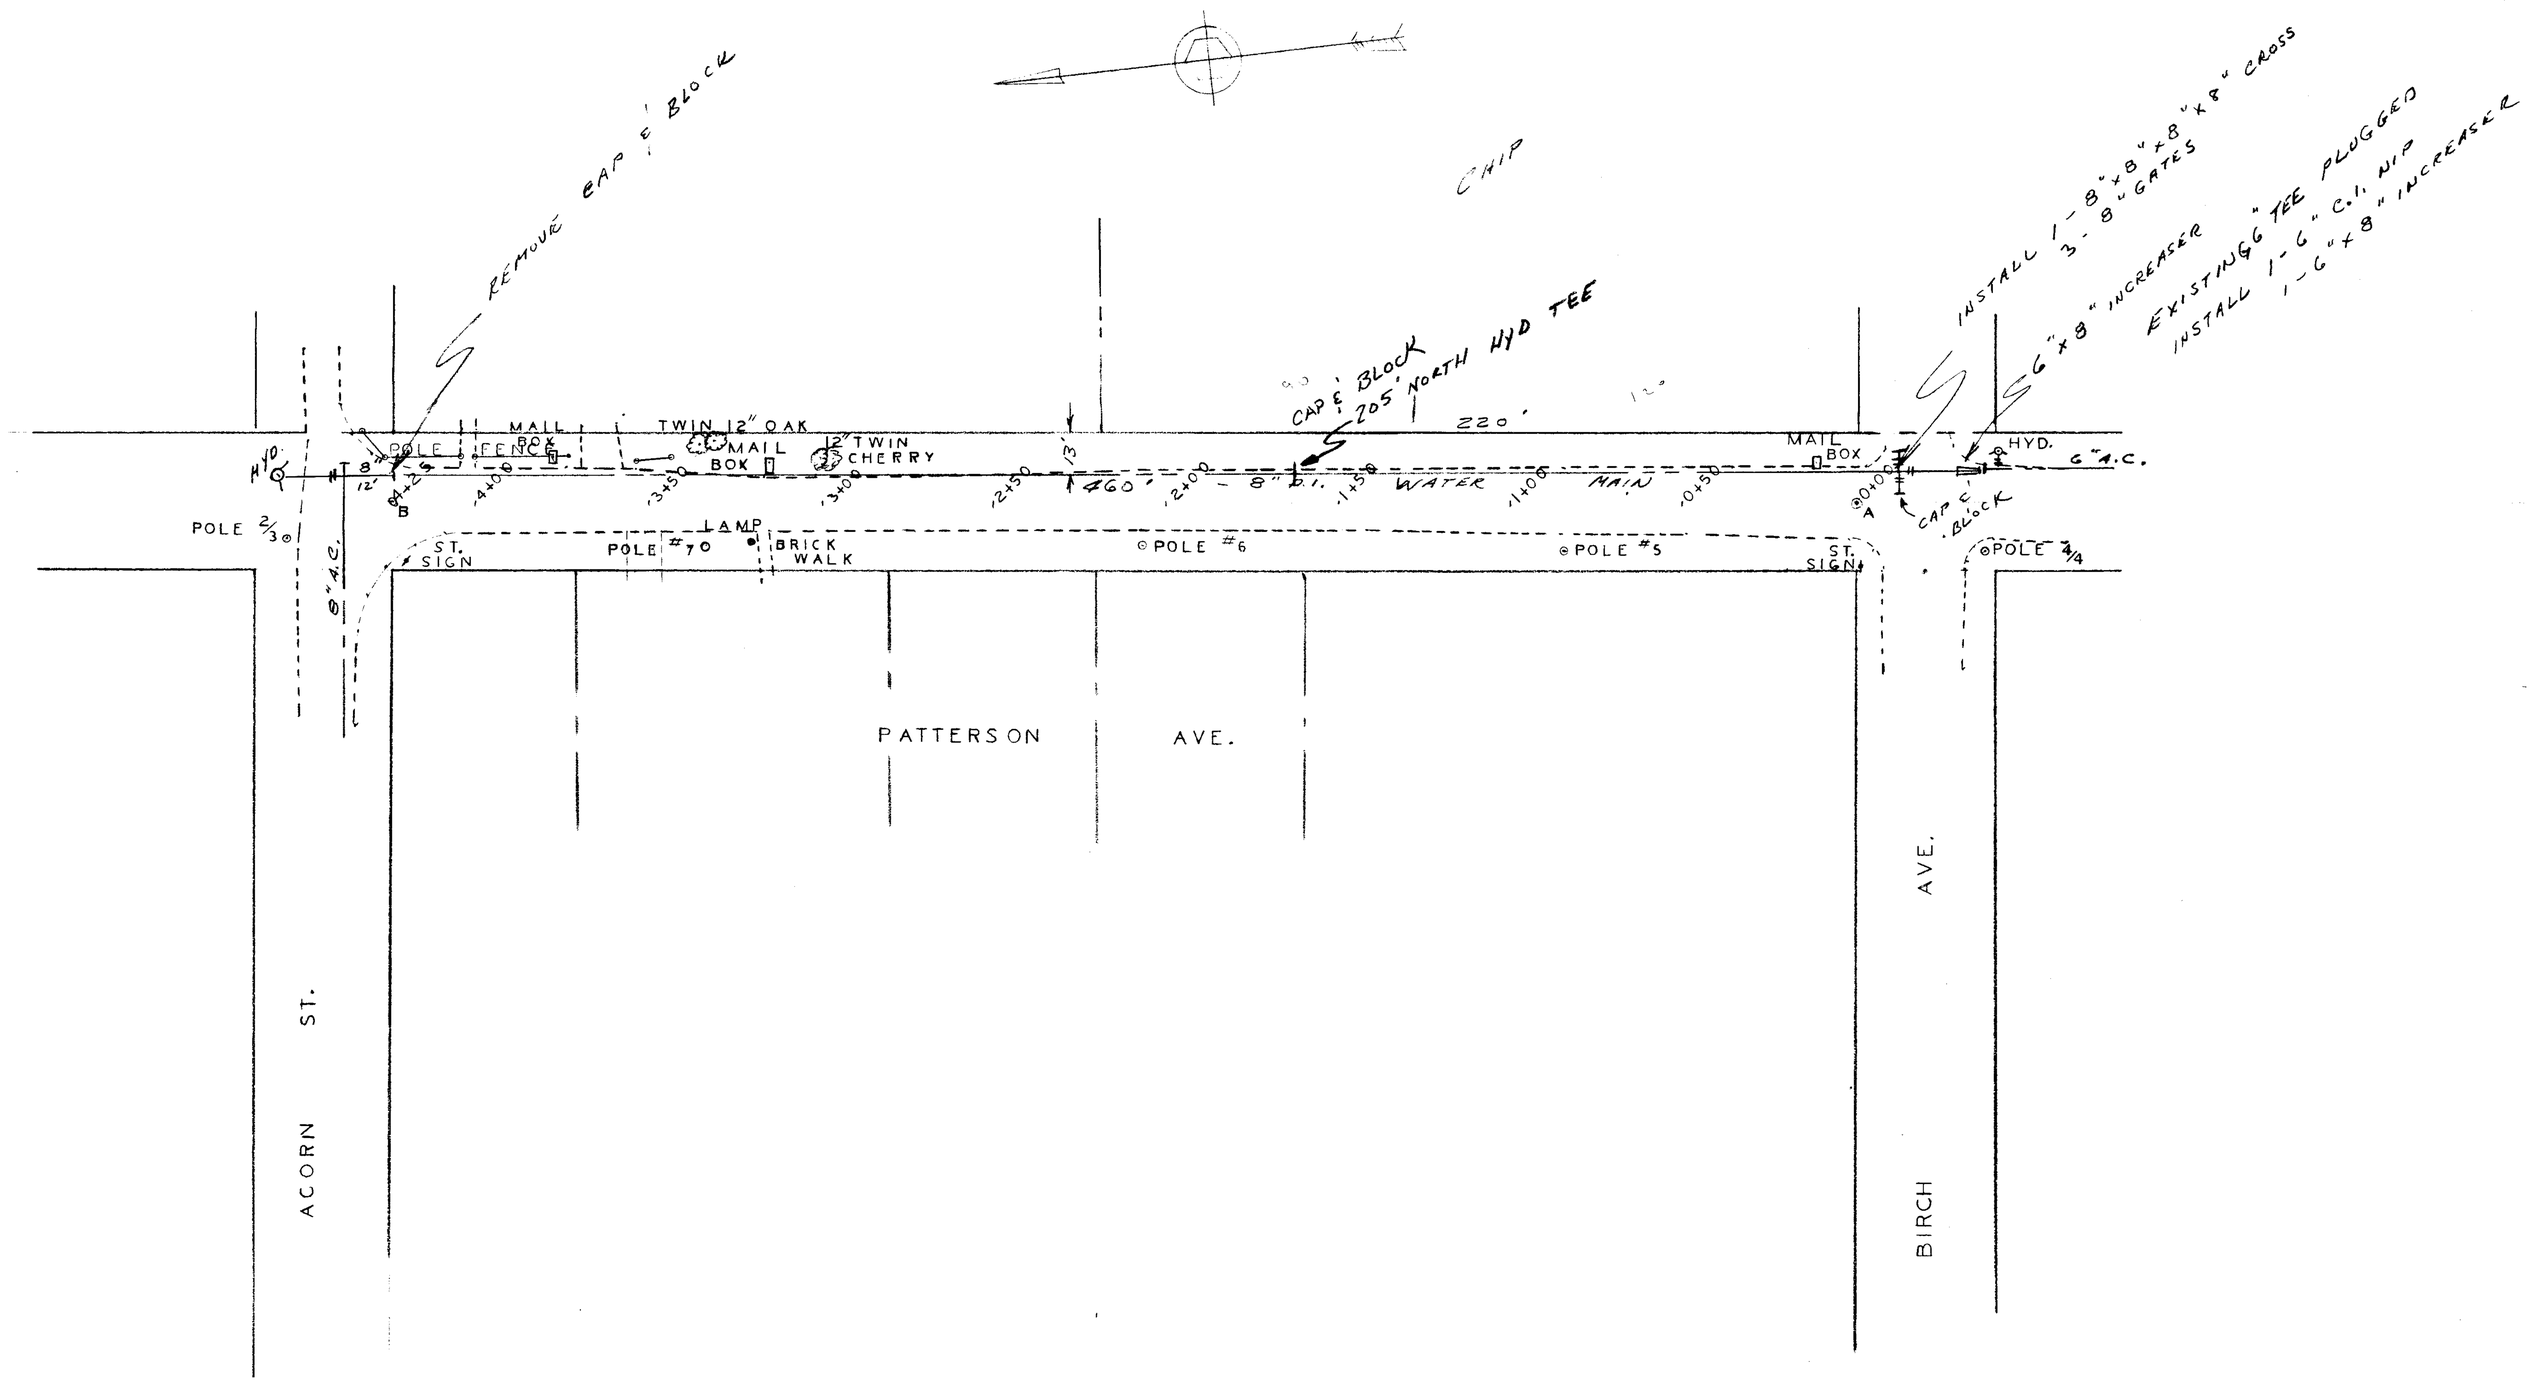

Proposed extension

PATTERSON AVE.

PROPOSED WATER MAIN

TOWN OF EAST LONGMEADOW, MASS.

SCALE: 1" = 40' AUGUST, 1984

A.A. MELIEN TOWN ENG.

W-3 CD 1