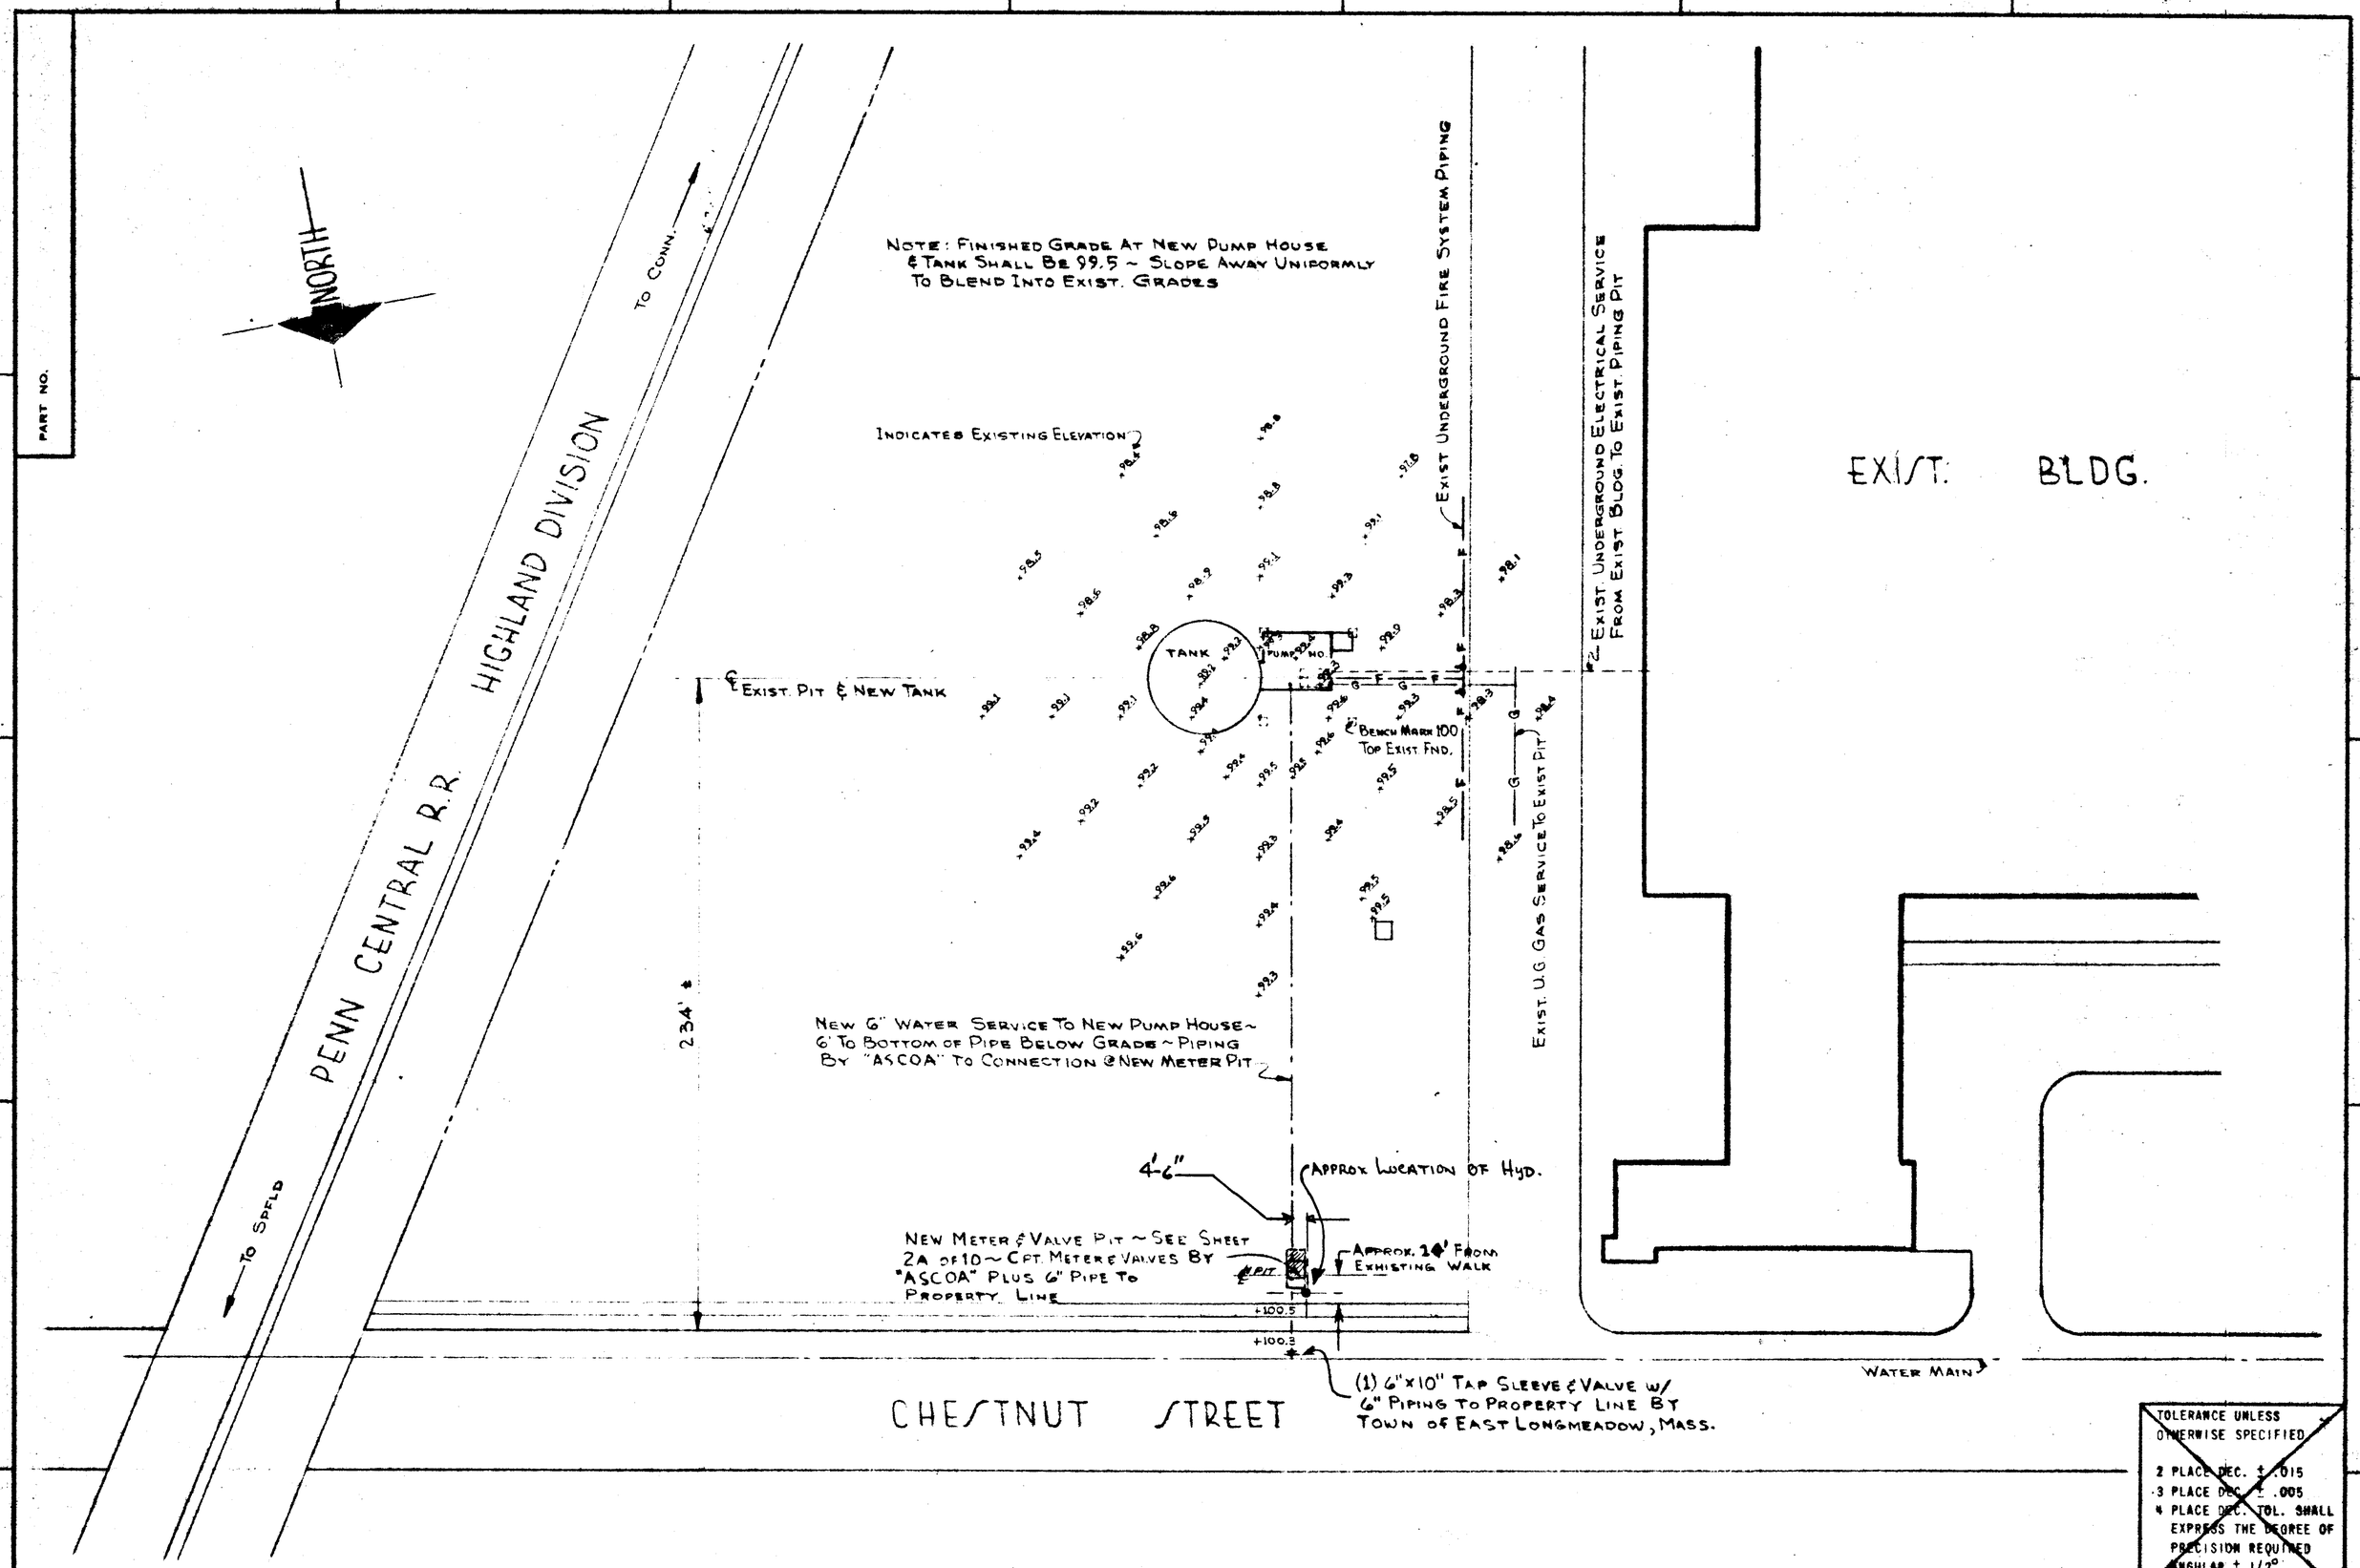

TOLERANCE UNLESS OTHERWISE SPECIFIED
2 PLACE DEC. ± .015
3 PLACE DEC. ± .005
4 PLACE DEC. TOL. SHALL EXPRESS THE DEGREE OF PRECISION REQUIRED
ANGULAR ± 1/2°

NOTICE

This drawing, and the subject-matter disclosed therein, embody proprietary information which is the confidential property of Package Machinery Company, none of which shall be copied, reproduced, disclosed to others, published, or used, in whole or in part, for any purpose, without the express advance written permission of a duly authorized agent of the Company. This drawing is subject to recall by Package Machinery Company at any time.

FOR ENG. USE ONLY	OPERATION	TOOL LIST

	REVISIONS
6	
5	
4	
3	
2	
1	ADDED CHG. IN CO. ON VALVE & METER PIT / 5-7-71 BRG

MATERIAL		DATE 2-10-1971
SIZE-PATTERN-FORGING		SCALE 1" = 40'
MACHINE TYPES		DRAWN J.L.M.
SUPERSEDES NO.	SUPERSEDED BY	CHECKED

PACKAGE MACHINERY COMPANY AND REED - PRENTICE DIV.
EAST LONGMEADOW, MASS

PART NAME: SECOND WATER SUPPLY-FIRE PROTECTION

PART NO.: PARTIAL SITE PLAN

SHEET 3 OF 10

W306