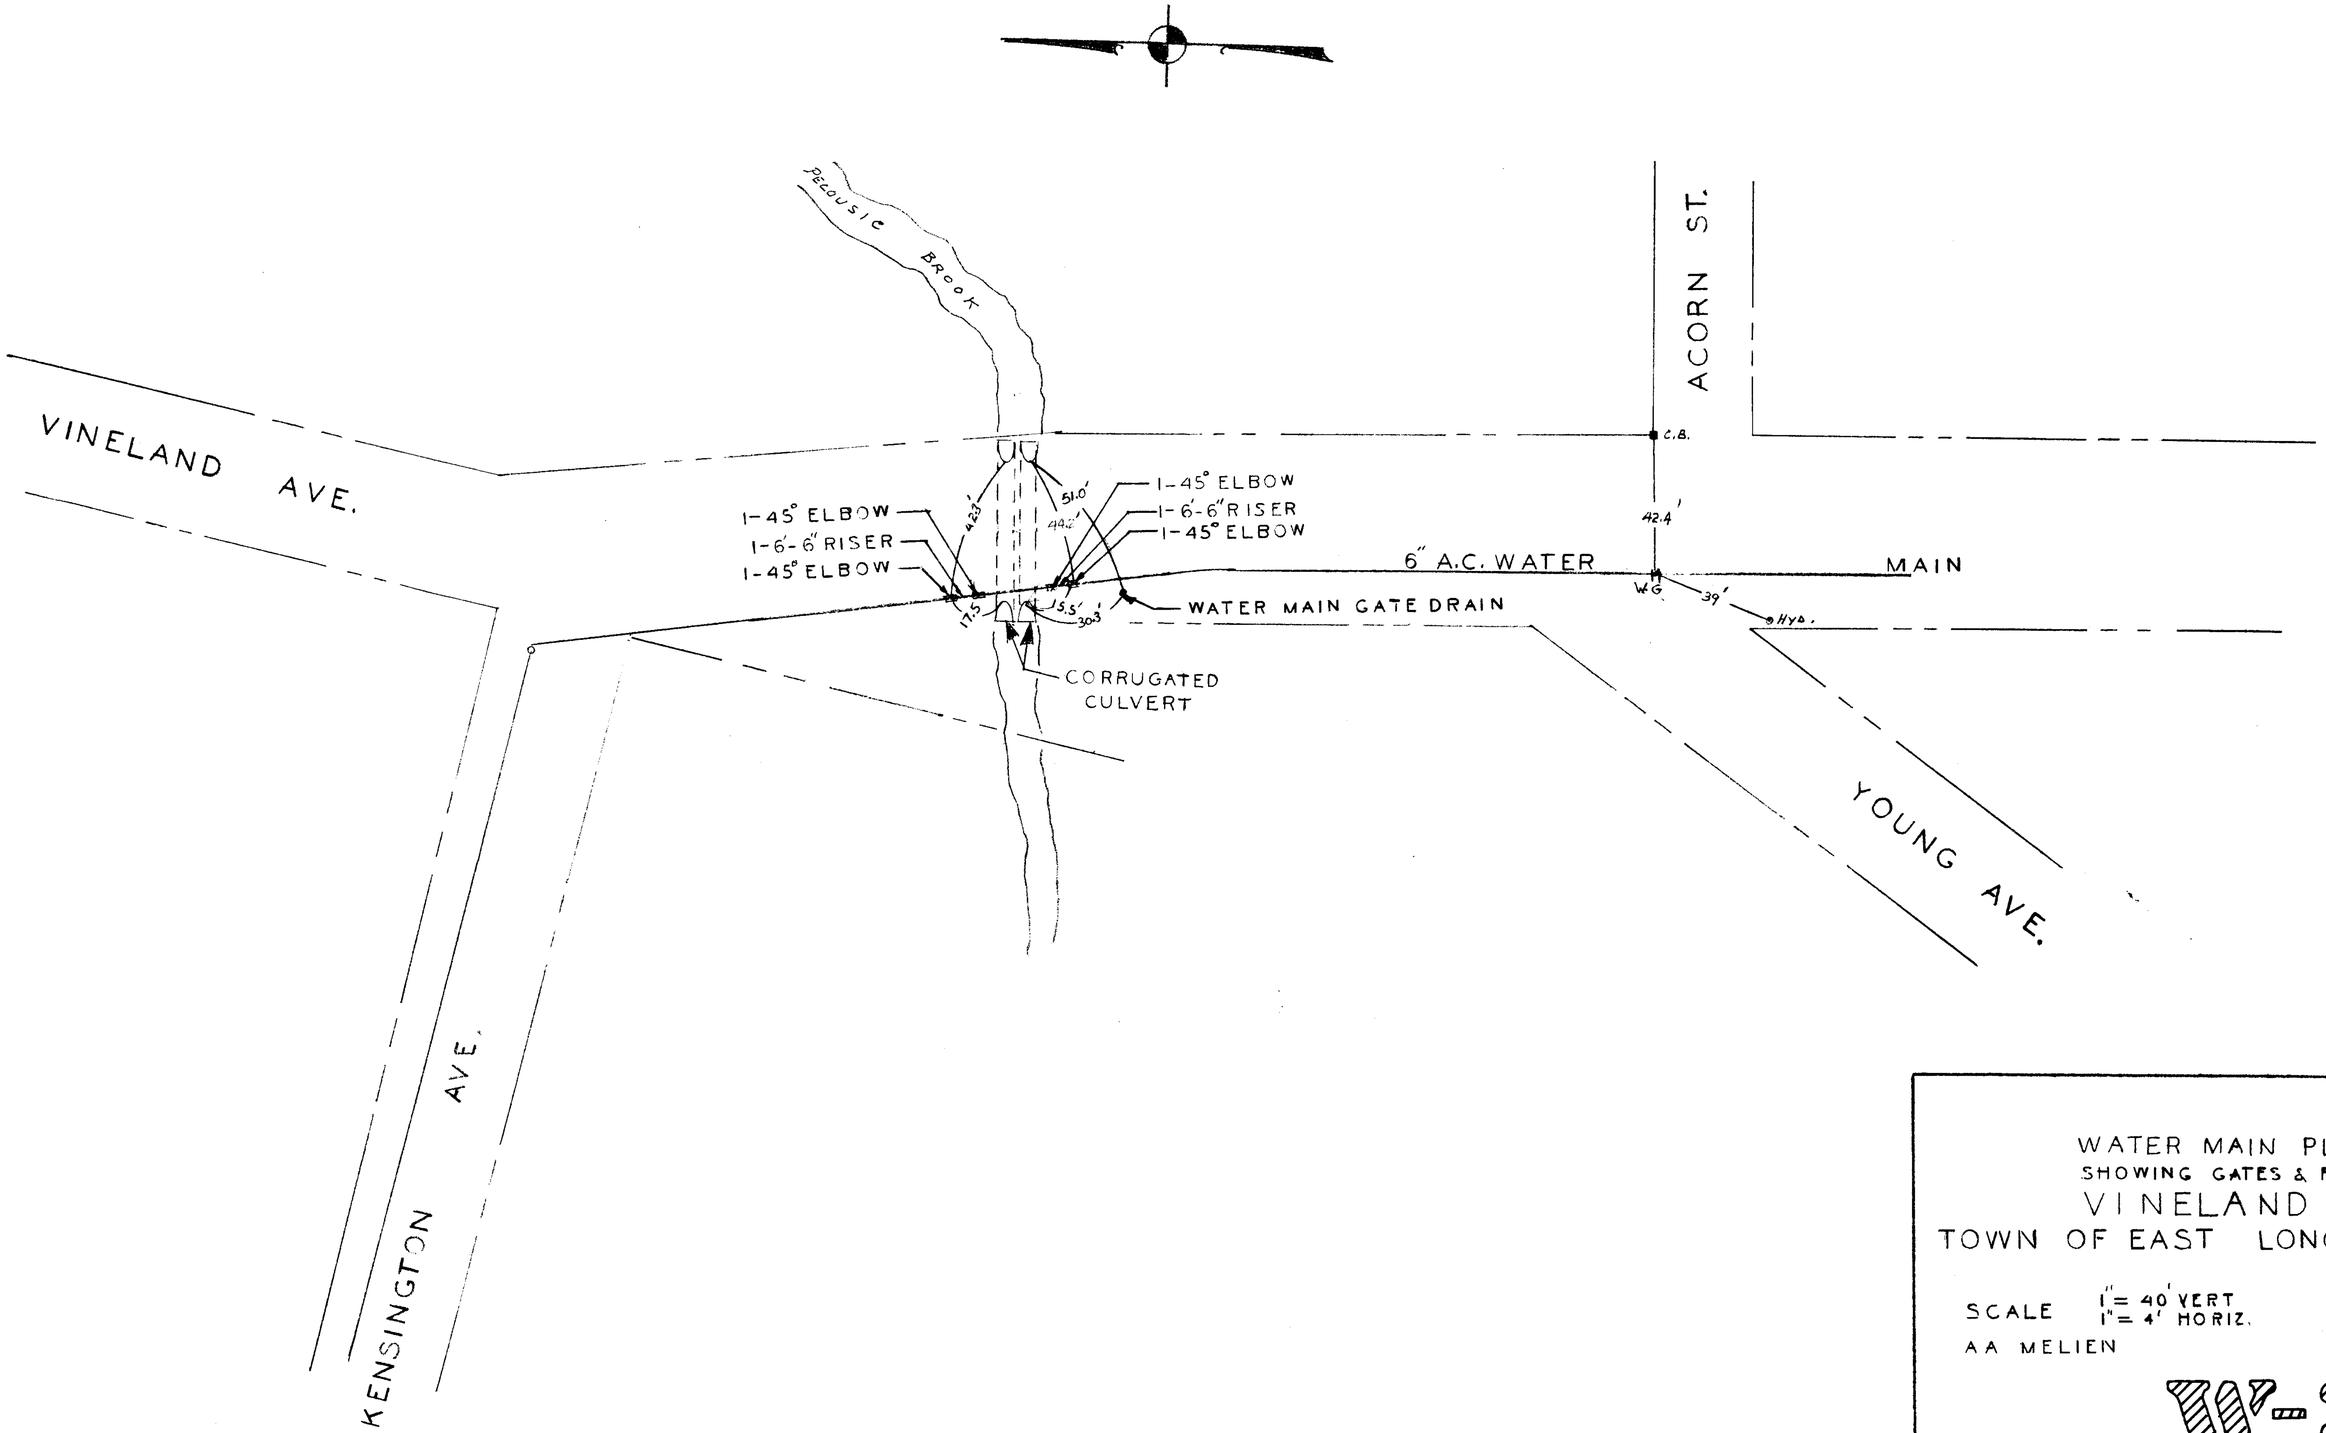

WATER MAIN PLAN
SHOWING GATES & FITTINGS
VINELAND AVE.
TOWN OF EAST LONGMEADOW

SCALE 1" = 40' VERT. 1" = 4' HORIZ. AUG. 1974

AA MELIEN ENGINEER

W-33 33