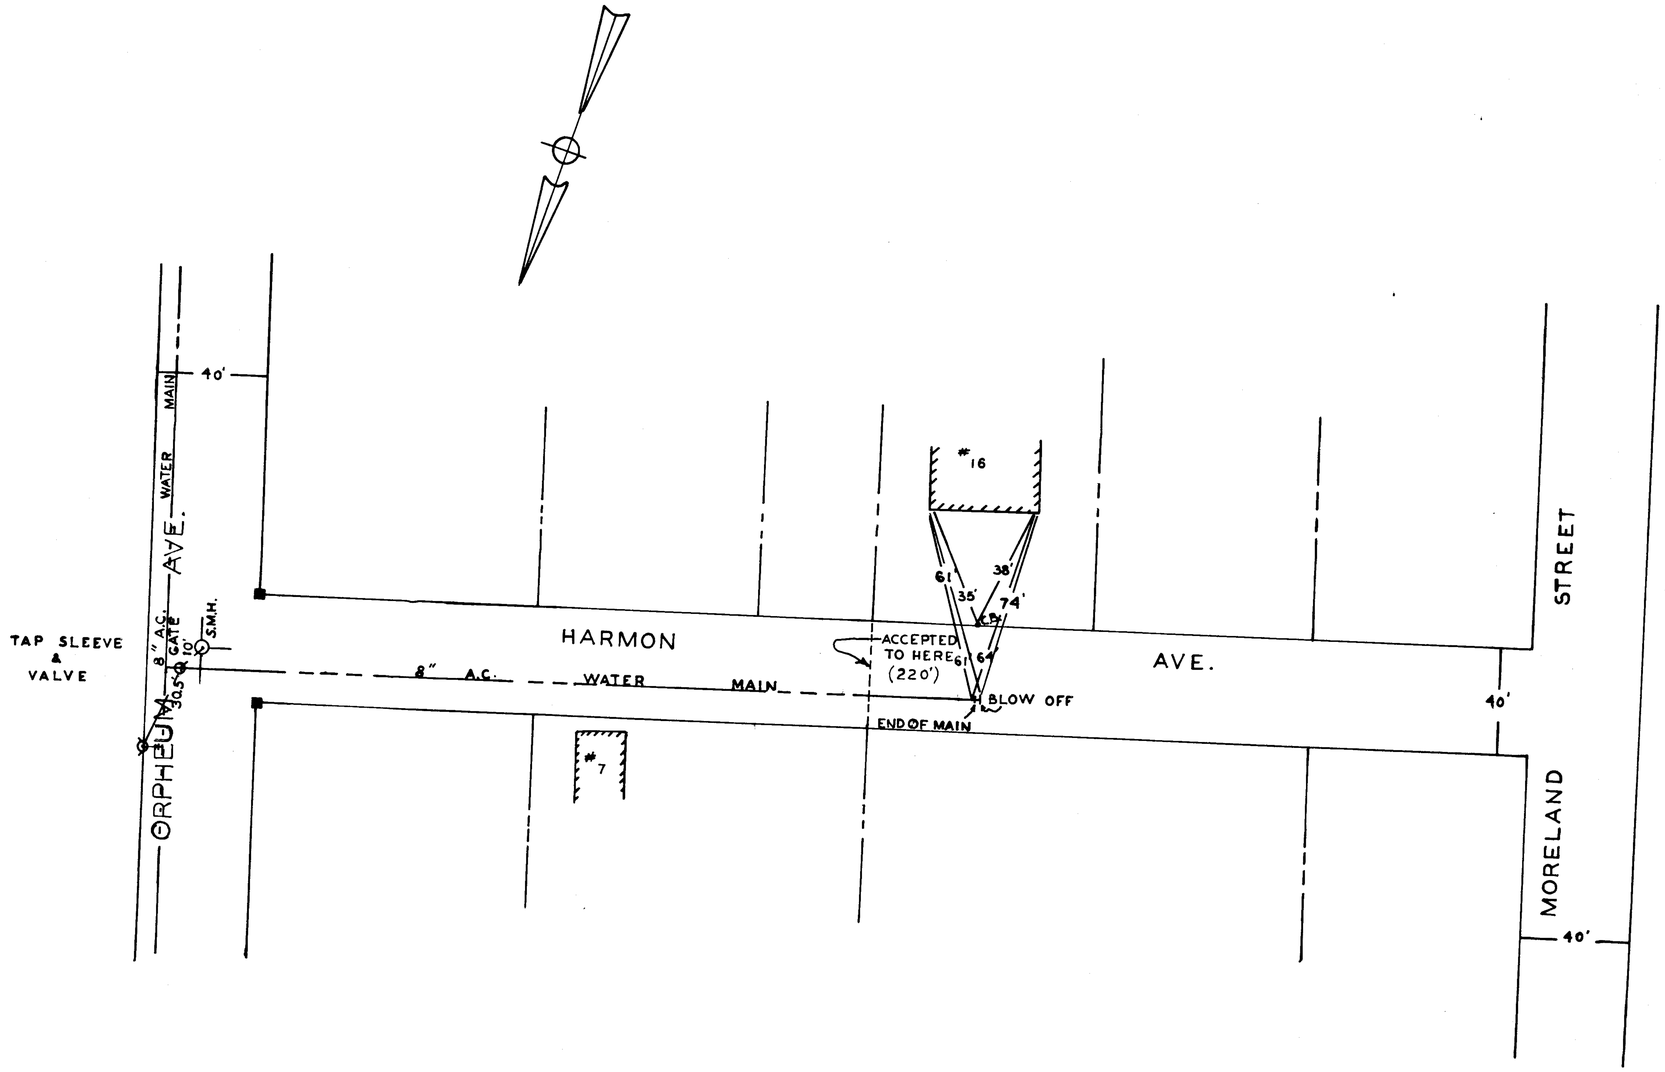

WATER MAIN PLAN

HARMON AVE.

TOWN OF EAST LONGMEADOW

SCALE: 1" = 40' HOR. 1" = 4' VERT. DEC. 1975

A.A. MELLEN

W-343