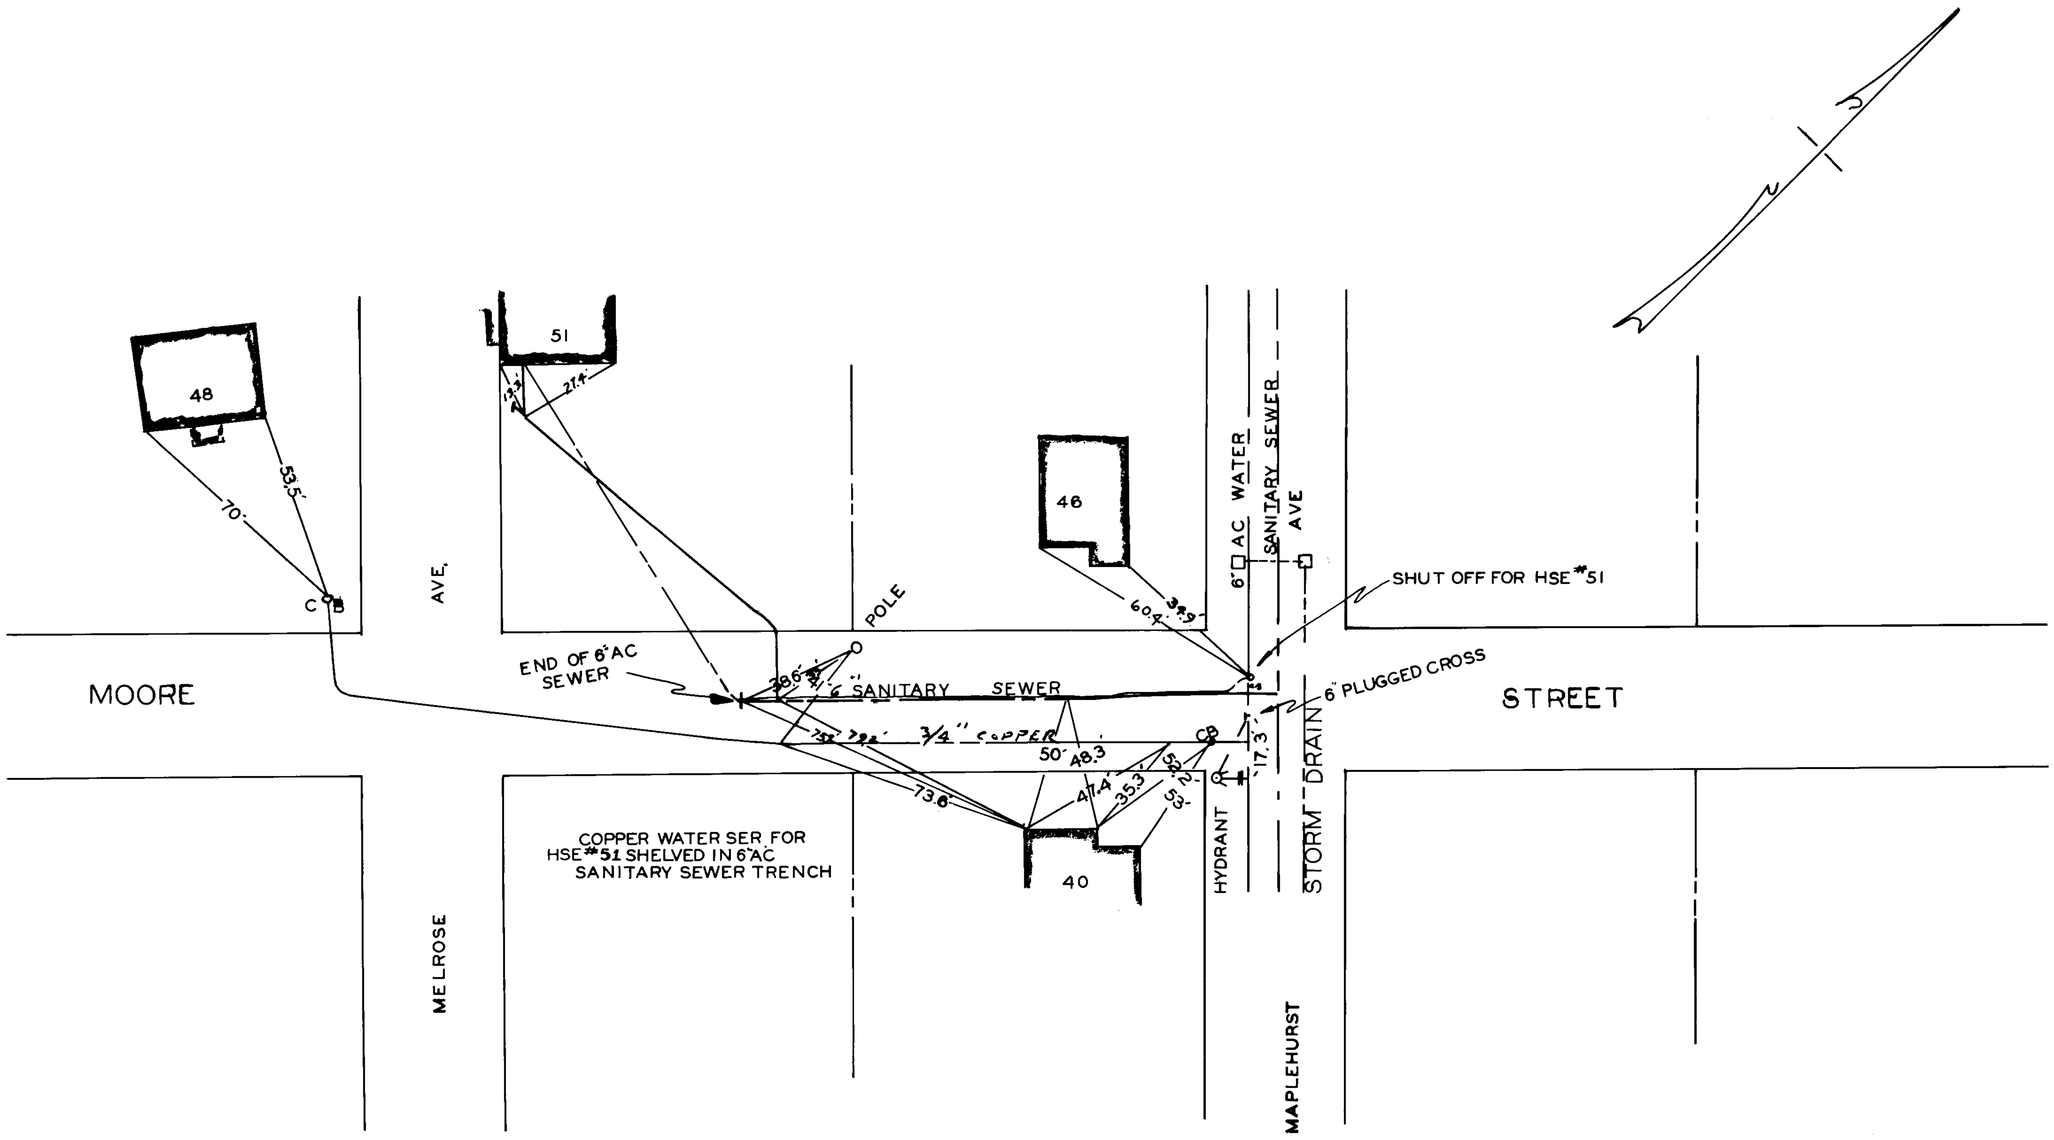

PLAN & PROFILE OF
SANITARY SEWER
MOORE STREET
EAST LONGMEADOW MA.
SCALE: 1" = 40' HOR.
1" = 4' VERT.
JUNE 1974
A. A. MELIEN TOWN ENG'R

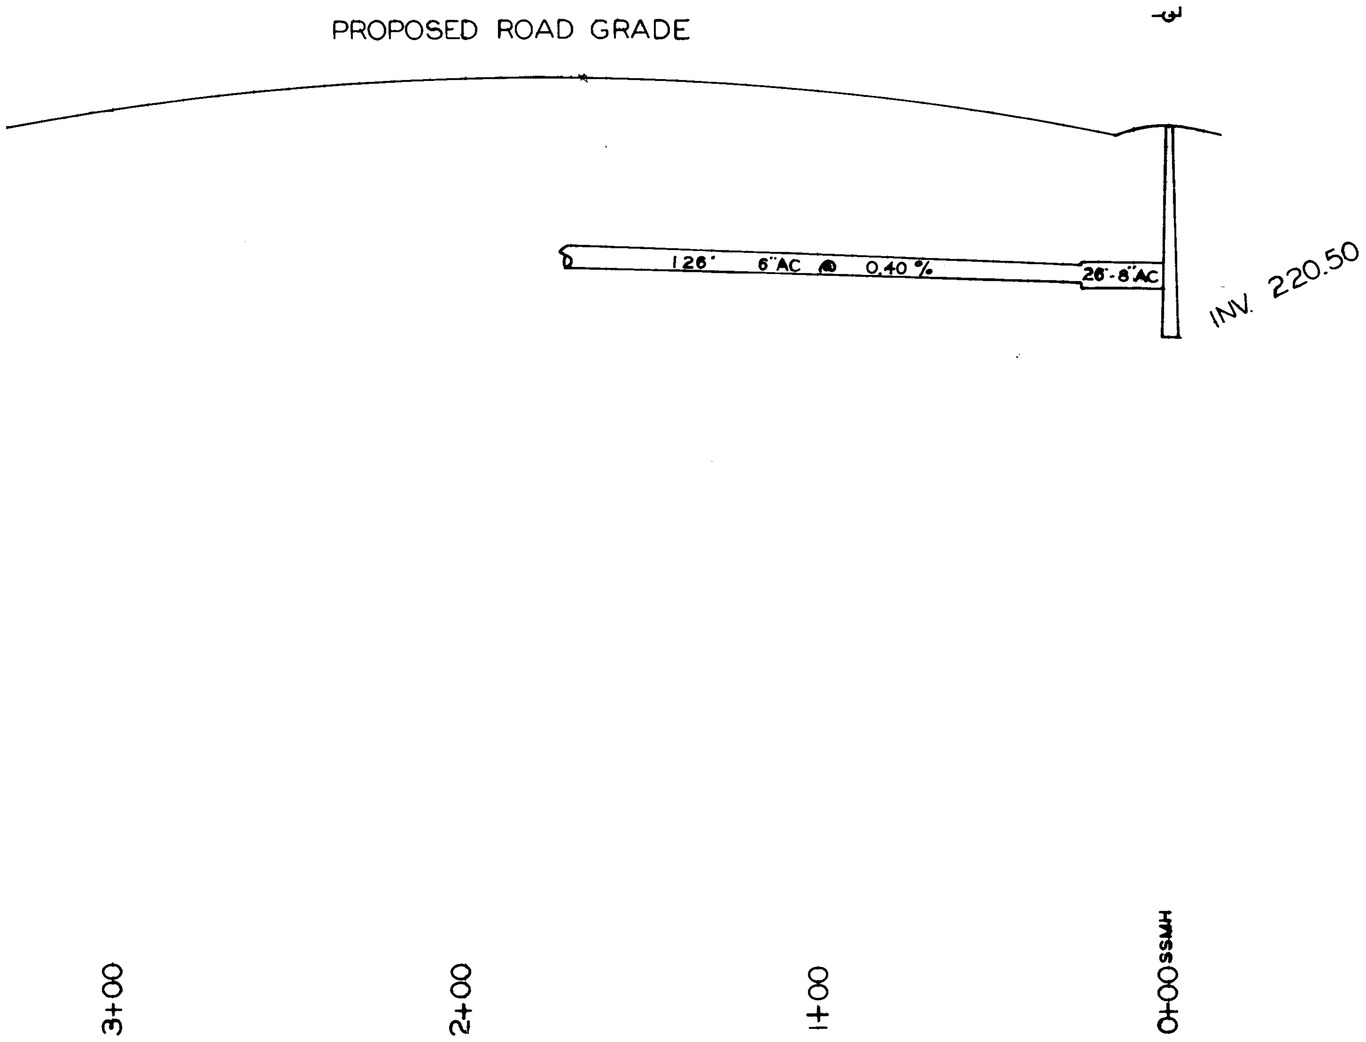

W 361