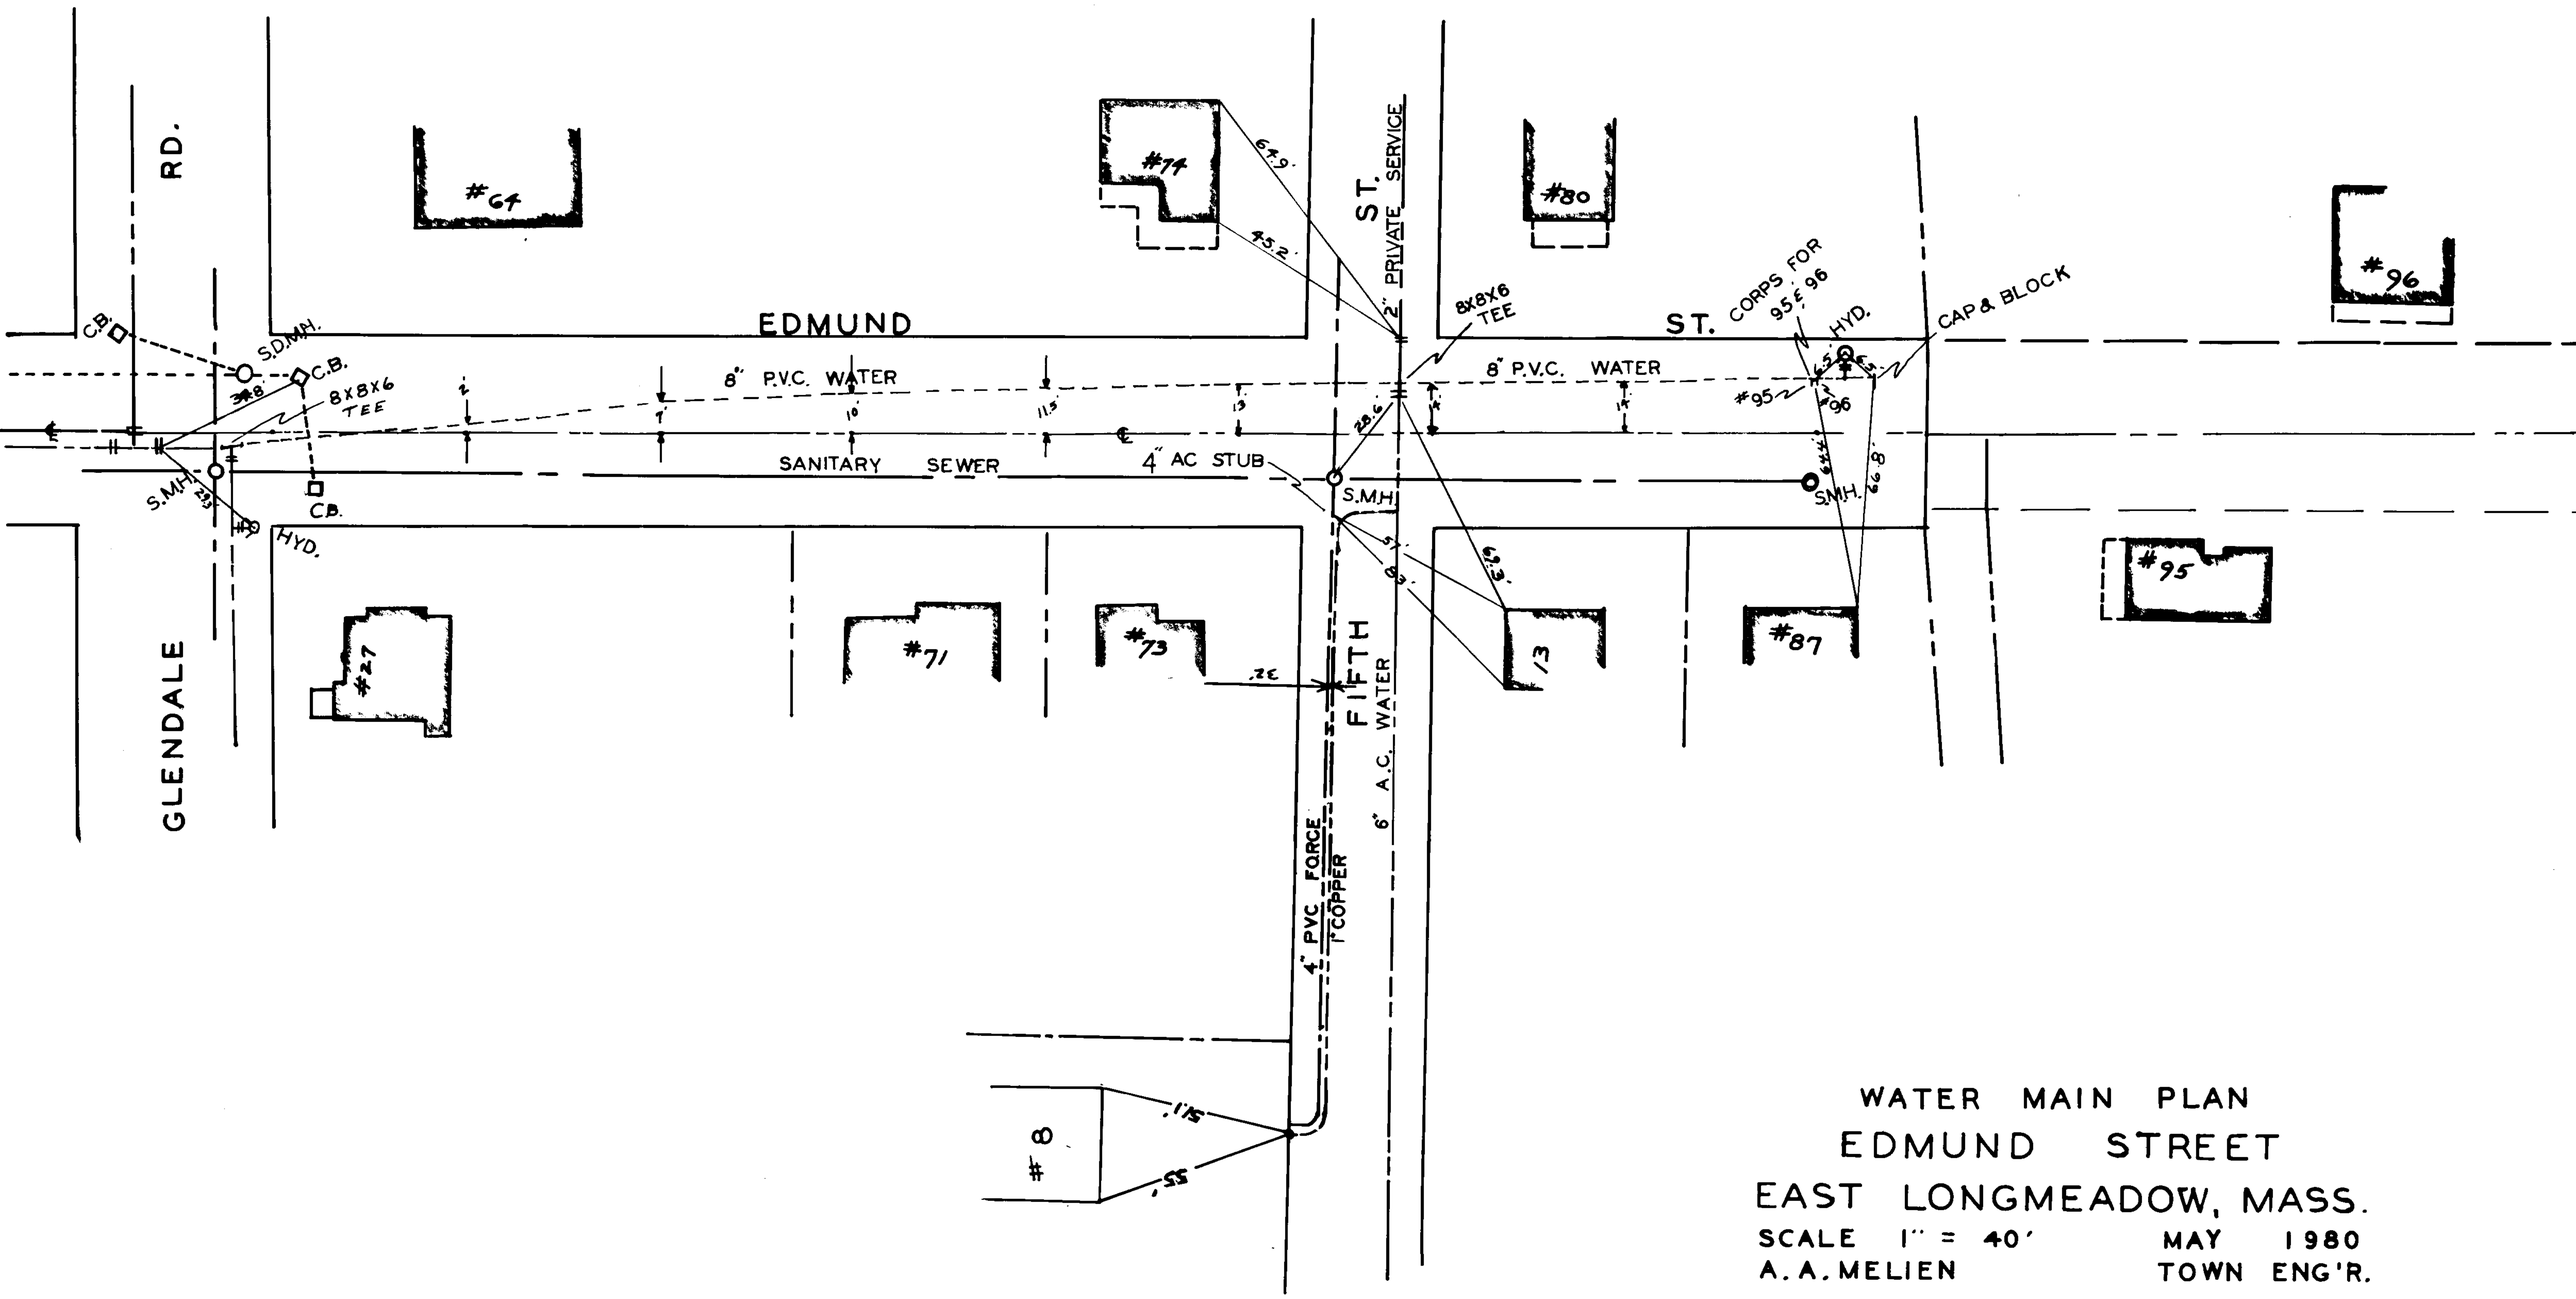

WATER MAIN PLAN

EDMUND STREET

EAST LONGMEADOW, MASS.

SCALE 1" = 40' MAY 1980

A. A. MELIEN TOWN ENG'R.

W-3375