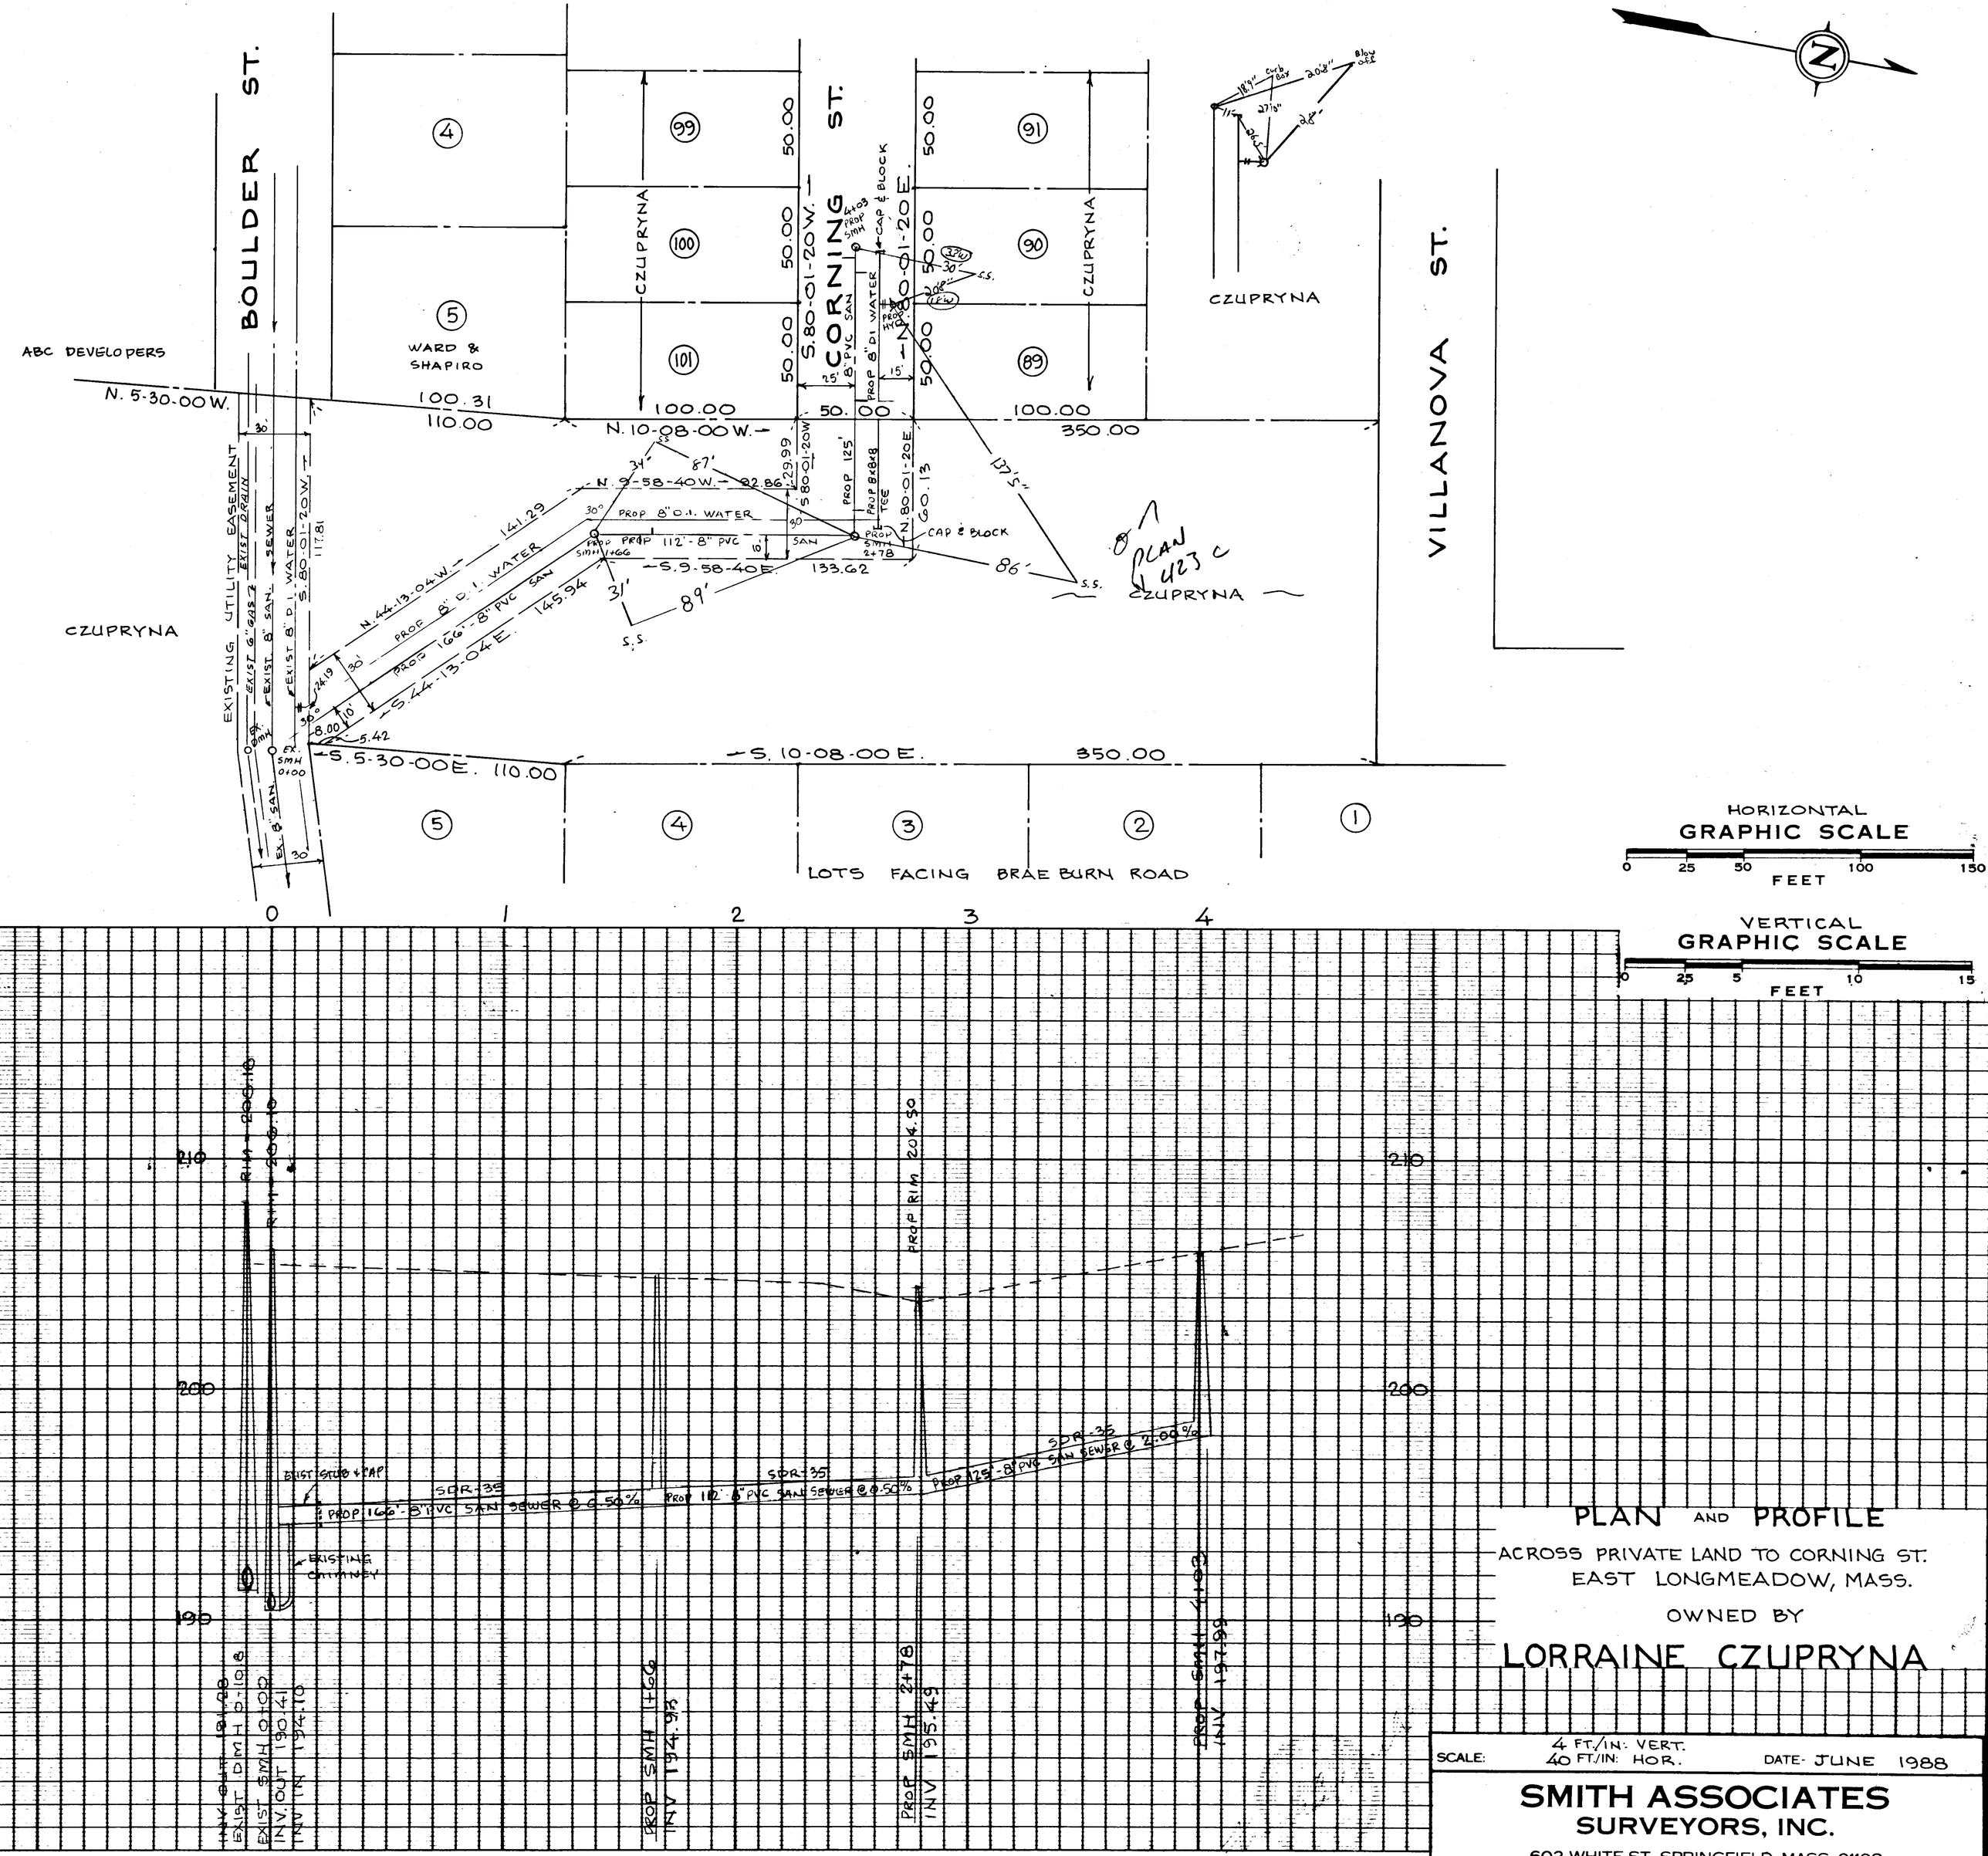
BOULDER ST.
CORNING ST.
VILLANOVA ST.
CZUPRYNA
ABC DEVELOPERS
WARD & SHAPIRO
N. 5-30-00 W.
N. 10-08-00 W.
S. 80-01-20 W.
N. 80-01-20 E.
N. 9-58-40 W.
S. 9-58-40 E.
N. 44-13-04 W.
S. 44-13-04 E.
S. 5-30-00 E.
S. 10-08-00 E.
100.31
110.00
100.00
50.00
350.00
PROP 8" D.I. WATER
PROP 112'-8" PVC SAN
PROP 166'-8" PVC SAN
PROP 8" D.I. WATER
PROP 125'-8" PVC SAN
PROP 8x8x8 TEE
CAP & BLOCK
EXISTING UTILITY EASEMENT
EXIST. DRAIN
EXIST. 6" GAS
EXIST. 8" SAN.
EXIST. 8" D.I. WATER
EX. 8" SAN.
EX. SMH 0+00
PROP SMH 1+66
PROP SMH 2+78
PLAN 423 C
LOTS FACING BRAE BURN ROAD
HORIZONTAL GRAPHIC SCALE
0 25 50 100 150
FEET
VERTICAL GRAPHIC SCALE
0 25 5 10 15
FEET
PROP RIM 204.50
SDR-35
PROP 166'-8" PVC SAN SEWER @ 0.50%
PROP 112'-8" PVC SAN SEWER @ 0.50%
PROP 125'-8" PVC SAN SEWER @ 2.00%
EXIST STUB & CAP
EXISTING CHIMNEY
PROP SMH 1+66
INV 194.95
PROP SMH 2+78
INV 195.49
PROP SMH 4+03
INV 197.99
EXIST DMH 0+19.8
EXIST SMH 0+00
INV. OUT 190.41
INV. IN 194.10
PLAN AND PROFILE
ACROSS PRIVATE LAND TO CORNING ST.
EAST LONGMEADOW, MASS.
OWNED BY
LORRAINE CZUPRYNA
SCALE: 4 FT./IN: VERT. 40 FT./IN: HOR.
DATE- JUNE 1988
SMITH ASSOCIATES
SURVEYORS, INC.
602 WHITE ST., SPRINGFIELD, MASS. 01108